

# OFFICE OF THE MARION COUNTY SURVEYOR

## SECTION RECORD CORNER

SECTION 8 TOWNSHIP 16 RANGE 5

DATE: 1-19-05 2-3-06

PARTY CHIEF: Wilcoxon

CREW: \_\_\_\_\_

TYPE OF MARKER: Harrison: old ties/GPS

METHOD OF ESTABLISHMENT: County: GPS

7-9-01



IN. S.P.C. E ZONE NAD '83

NAME: 16050805

N: 510711.9350(m)

E: 71402.9117(m)

NOTE: This corner position represents a title corner and may not necessarily be in the position of the Record corner.

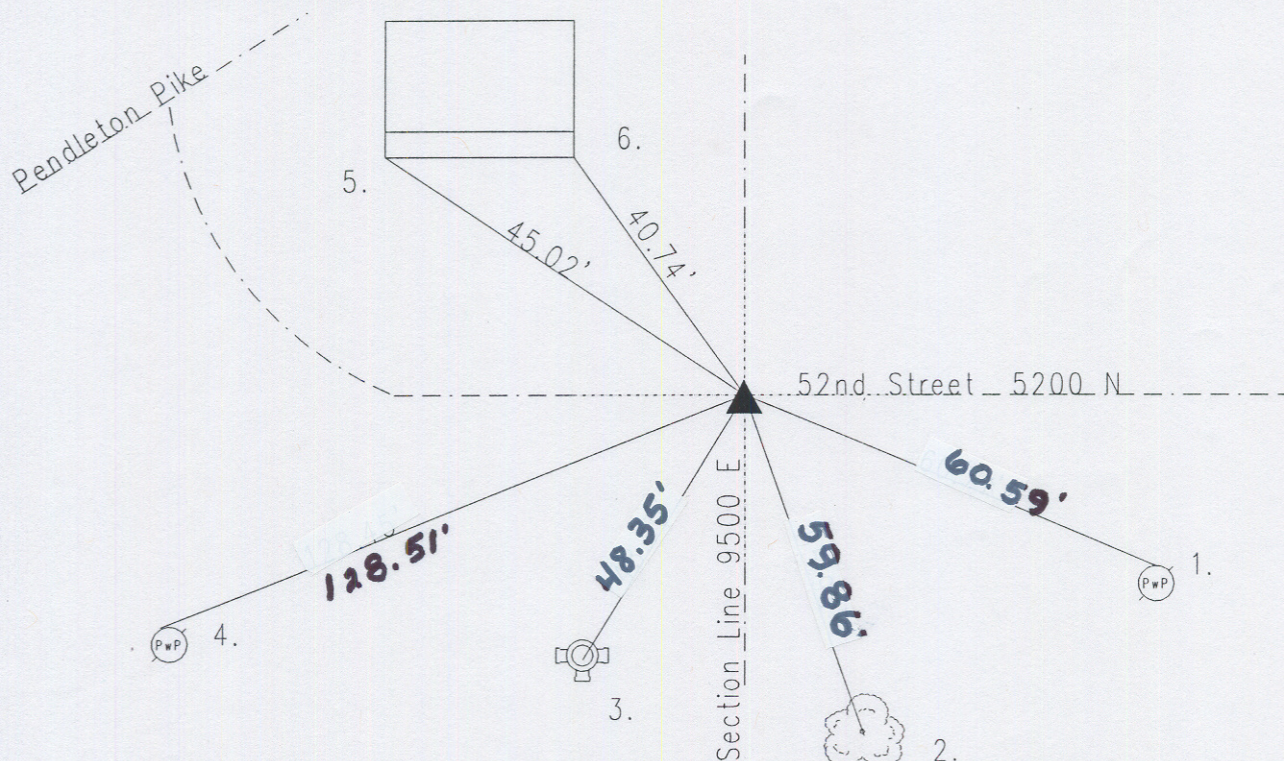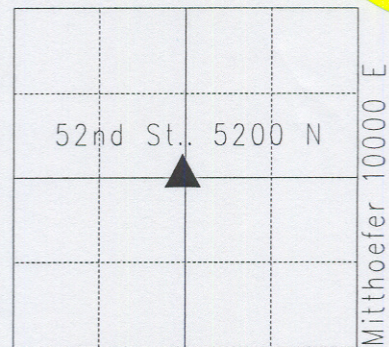

16050805

REF.	DISTANCE	DESCRIPTION
1.	60.59'	Mag nail w/brass washer NF PwP#503-381BA 8"up
2.	59.86'	Boat spike W twin hackberry 24"up
3.	48.35'	Top nut of fire hydrant
4.	128.51'	Mag nail w/brass washer N PwP#502-381AA 18"up
5.	45.02'	SW corner of porch ADDRESS 9462
6.	40.74'	SE corner of porch ADDRESS 9462

### 16050805 Center corner

**CORNER HISTORY:** Reference dated 11-7-1949 by Ed Hearne tied corner but did not give description of corner marker. Reference dated 3-4-75 by Fortner called a road nail. Reference dated 6-3-86 by Greene called road nail. Reference dated 9-24-96 by Wilcoxon called found PK nail w/washer. Reference dated 7-9-01 by Whiteside called the same. Reference dated 1-19-05 by Wilcoxon called set survey mark nail. Reference dated 1-23-05 by Wilcoxon called re-checked ties to house from the corner using bearing, bearing, intersection, GPS coordinates. Reference dated 1-11-06 by Wilcoxon called set Harrison per coordinates; found concrete road 16" down, no other points were located. Harrison stands.